


FRONT ISOMETRIC VIEW

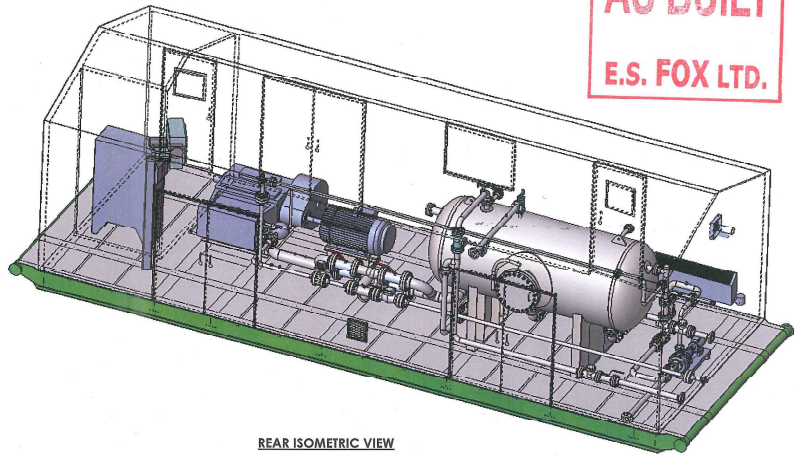

REAR ISOMETRIC VIEW

**AS BUILT**  
**E.S. FOX LTD.**

(1) REQ'D

TIMECARD:  
  
12-2026-15-6S-6605

△				
△	REMOVED FROM EXISTING DESIGN	JL		10/09/19
△	REQUIRED CHARGE PUMP DESIGN (PQ) OVERALL HEIGHT	JL		10/09/19
△	REQUIRED INTERNAL PREPARATION SPEC	JL		10/11/19
△	ISSUED FOR CONSTRUCTION	JL		10/11/19
	REVISION	PREPARED BY	DESIGNED BY	DATE



JOB: WEATHERCRO CANADA  
300 HP VERTICAL ISOBAY PUMP COMBO LINE  
TITLE: PIPING LAYOUT FOR 60" VESSEL / 300 HP QUANTUM PUMP PACKAGE

SERIAL NO. 12-2026-6605	DATE
DESIGN APPROVAL	DATE
DESIGNED BY	DATE
PREPARED BY J. SABLON	DATE 12/08/21
END FILE	REVISED NO. 12-2026-6605 LAYOUT
SCALE: 1/8" = 1'-0"	DATE 12/08/21